

DDC Controls for:

NASA Infrared Telescope Facility





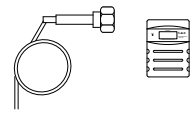
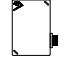
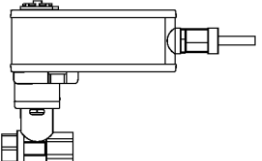
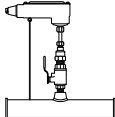
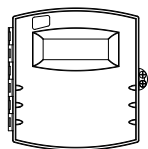
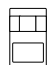
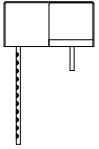
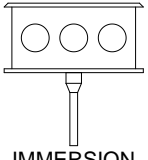
Mauna Kea, HI

Designed and installed by:

BIAC

73-5620 Kauhul St. Unit#6
Kailua Kona, HI 96740

CONTROLS LEGEND

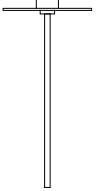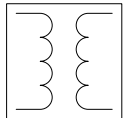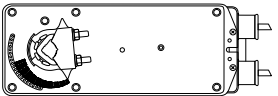GENERAL SENSORS	 DUCT	TRANSFORMER		DAMPER ACTUATORS		CURRENT SENSORS	
DIFFERENTIAL PRESSURE	 MONITOR	CONTROL RELAYS	 PAM / RIB	VALVE ACTUATORS	 BALL	WATER AND STEAM FLOW	 MONITOR
POWER MONITORS		WALL MOUNTED THERMOSTATS		DUCT SMOKE DETECTOR		TEMPERATURE SENSORS	 IMMERSION
















DRAWING INDEX

PAGE NUM	DESCRIPTION
1	COVER PAGE
2	CONTROLS LEGEND
3	ATC PANEL LAYOUT
4	SYSTEM ARCHITECTURE
5	ATC SLOTS 1-3
6	ATC SLOTS 4-6
7	ATC SLOTS 7-9
8	ATC SLOT 10
9	ATC EQUIPMENT A
10	ATC EQUIPMENT B
11	ATC EQUIPMENT C
12	TU (TYP.)
13	FLOOR PLAN

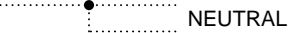ABBREVIATIONS

ADD ADDRESS	HE HEAT EXCHANGER	HOA HAND-OFF-AUTO
AHU AIR HANDLER	HP HEAT PUMP	HPS HIGH PRESSURE STEAM
AI ANALOG INPUT	HTG HEATING	HWS/R HOT WATER SUPPLY / RETURN
AO ANALOG OUTPUT	IW ICE WAGON	LPC LOW PRESSURE CONDENSATE
AV ANALOG VARIABLE	LPS LOW PRESSURE STEAM	MS/TP MASTER SLAVE TOKEN PASSING
BAS BUILDING AUTOMATION SYSTEM	OSA OUTSIDE AIR TEMP	OVRD OVERRIDE
BMS BUILDING MANAGEMENT SYSTEM	PRESS PRESSURE	RAT RETURN AIR TEMP
BV BINARY VALUE	RM ROOM	RF RETURN FAN
CH CHILLER	RW RETURN WATER	SA SUPPLY AIR
CLG COOLING	SA SUPPLY AIR	SF SUPPLY FAN
COMP COMPRESSOR	SMK SMOKE	SP SET POINT
CP CONDENSER PUMP	SPD SPEED	STS STATUS
CT COOLING TOWER	SW SUPPLY WATER	TCP TEMPERATURE CONTROL PANEL
CU COMMAND UNIT	TCV TEMPERATURE CONTROL VALVE	TYP TYPICAL
CUH CABINET UNIT HEATER	TU TERMINAL UNIT	VAV VARIABLE AIR VOLUME
CLG COOLING	VLV VALVE	VP VELOCITY PRESSURE
CMD COMMAND	XP TRANSFORMER PANEL	
COND CONDENSER		
CV CONSTANT VOLUME		
CWS/R COLD WATER SUPPLY / RETURN		
DAT DISCHARGE AIR TEMP		
DDC DIRECT DIGITAL CONTROLS		
DI DIGITAL INPUT		
DMPR DAMPER		
DP DIFFERENTIAL PRESSURE		
EA EXHAUST AIR		
EDH ELECTRIC DUCT HEATER		
EF EXHAUST FAN		
EMS EMERGENCY MANAGEMENT SYSTEM		
FACP FIRE ALARM CONTROL PANEL		
FLT FILTER		
FSD FIRE SMOKE DAMPER		

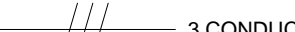WIRING STANDARDS
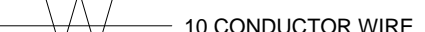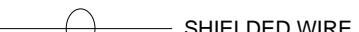
<p>L WIRE BACK TO TRANSFORMER LIVE</p> <p>N WIRE BACK TO TRANSFORMER NEUTRAL</p>	<p> WIRE NUT CONNECTION</p> <p> TERMINAL STRIP CONNECTION</p>																				
<p> 120 VOLT</p> <p> 24 VAC</p> <p> NEUTRAL</p> <p> COMMUNICATIONS</p> <p> SENSOR</p> <p> OUTPUT/COMMAND</p> <p> 2 CONDUCTOR WIRE</p> <p> 3 CONDUCTOR WIRE</p> <p> 4 CONDUCTOR WIRE</p> <p> 6 CONDUCTOR WIRE</p>	<p> 10 CONDUCTOR WIRE</p> <p> SHIELDED WIRE</p> <p> GROUND</p>																				
<table border="0" style="width: 100%;"> <thead> <tr> <th style="text-align: left;">WIRE</th> <th style="text-align: left;">APPLICATION</th> </tr> </thead> <tbody> <tr> <td>22/2 ORANGE STRIPE</td> <td>INPUT/SENSOR APP.</td> </tr> <tr> <td>22/2 PURPLE WIRE SHLD.</td> <td>24VAC POWER</td> </tr> <tr> <td>22/2 BLUE STRIPE</td> <td>24VAC POWER</td> </tr> <tr> <td>22/4 BLUE STRIPE</td> <td>OUTPUT/COMMAND APP.</td> </tr> <tr> <td>22/4 WHITE JACKET</td> <td>MISC. 4 WIRE APP.</td> </tr> <tr> <td>22/6 WHITE JACKET</td> <td>MISC. 6 WIRE APP.</td> </tr> <tr> <td>22/3 ORANGE STRIPE</td> <td>MISC. 3 WIRE APP.</td> </tr> <tr> <td>22/10 WHITE JACKET</td> <td>MISC. 10 WIRE APP.</td> </tr> <tr> <td>24/2 ORANGE WIRE SHLD.</td> <td>COMMUNICATIONS WIRE</td> </tr> </tbody> </table> <p>NOTE: ALL STRIPED WIRE HAVE WHITE JACKET UNLESS NOTED OTHERWISE.</p>		WIRE	APPLICATION	22/2 ORANGE STRIPE	INPUT/SENSOR APP.	22/2 PURPLE WIRE SHLD.	24VAC POWER	22/2 BLUE STRIPE	24VAC POWER	22/4 BLUE STRIPE	OUTPUT/COMMAND APP.	22/4 WHITE JACKET	MISC. 4 WIRE APP.	22/6 WHITE JACKET	MISC. 6 WIRE APP.	22/3 ORANGE STRIPE	MISC. 3 WIRE APP.	22/10 WHITE JACKET	MISC. 10 WIRE APP.	24/2 ORANGE WIRE SHLD.	COMMUNICATIONS WIRE
WIRE	APPLICATION																				
22/2 ORANGE STRIPE	INPUT/SENSOR APP.																				
22/2 PURPLE WIRE SHLD.	24VAC POWER																				
22/2 BLUE STRIPE	24VAC POWER																				
22/4 BLUE STRIPE	OUTPUT/COMMAND APP.																				
22/4 WHITE JACKET	MISC. 4 WIRE APP.																				
22/6 WHITE JACKET	MISC. 6 WIRE APP.																				
22/3 ORANGE STRIPE	MISC. 3 WIRE APP.																				
22/10 WHITE JACKET	MISC. 10 WIRE APP.																				
24/2 ORANGE WIRE SHLD.	COMMUNICATIONS WIRE																				

GENERAL NOTES

1. All communication wire must be Andover Control specified wire.
2. Current Andover Control Literature is to be used as a supplement to information contained herein.
3. Electronic devices used for control may not operate correctly when influenced by high noise areas, such as petra-chemical installations, electronic rooms and near hospital NMR or X-ray rooms.

As Built

HVAC/Controls
Security/Access Controls
Service and Monitoring

BIAC



PROJECT: NASA INFRARED TELESCOPE FACILITY

DRAWING TITLE: CONTROLS LEGEND

REVISIONS:

DRAWN BY: AG

ENG. BY: JL

CHK'D BY: JL


DATE: 8-13-13

JOB NO.

DWG NO. TC-2 of 14

ATC-1

Located in Mach RM 109

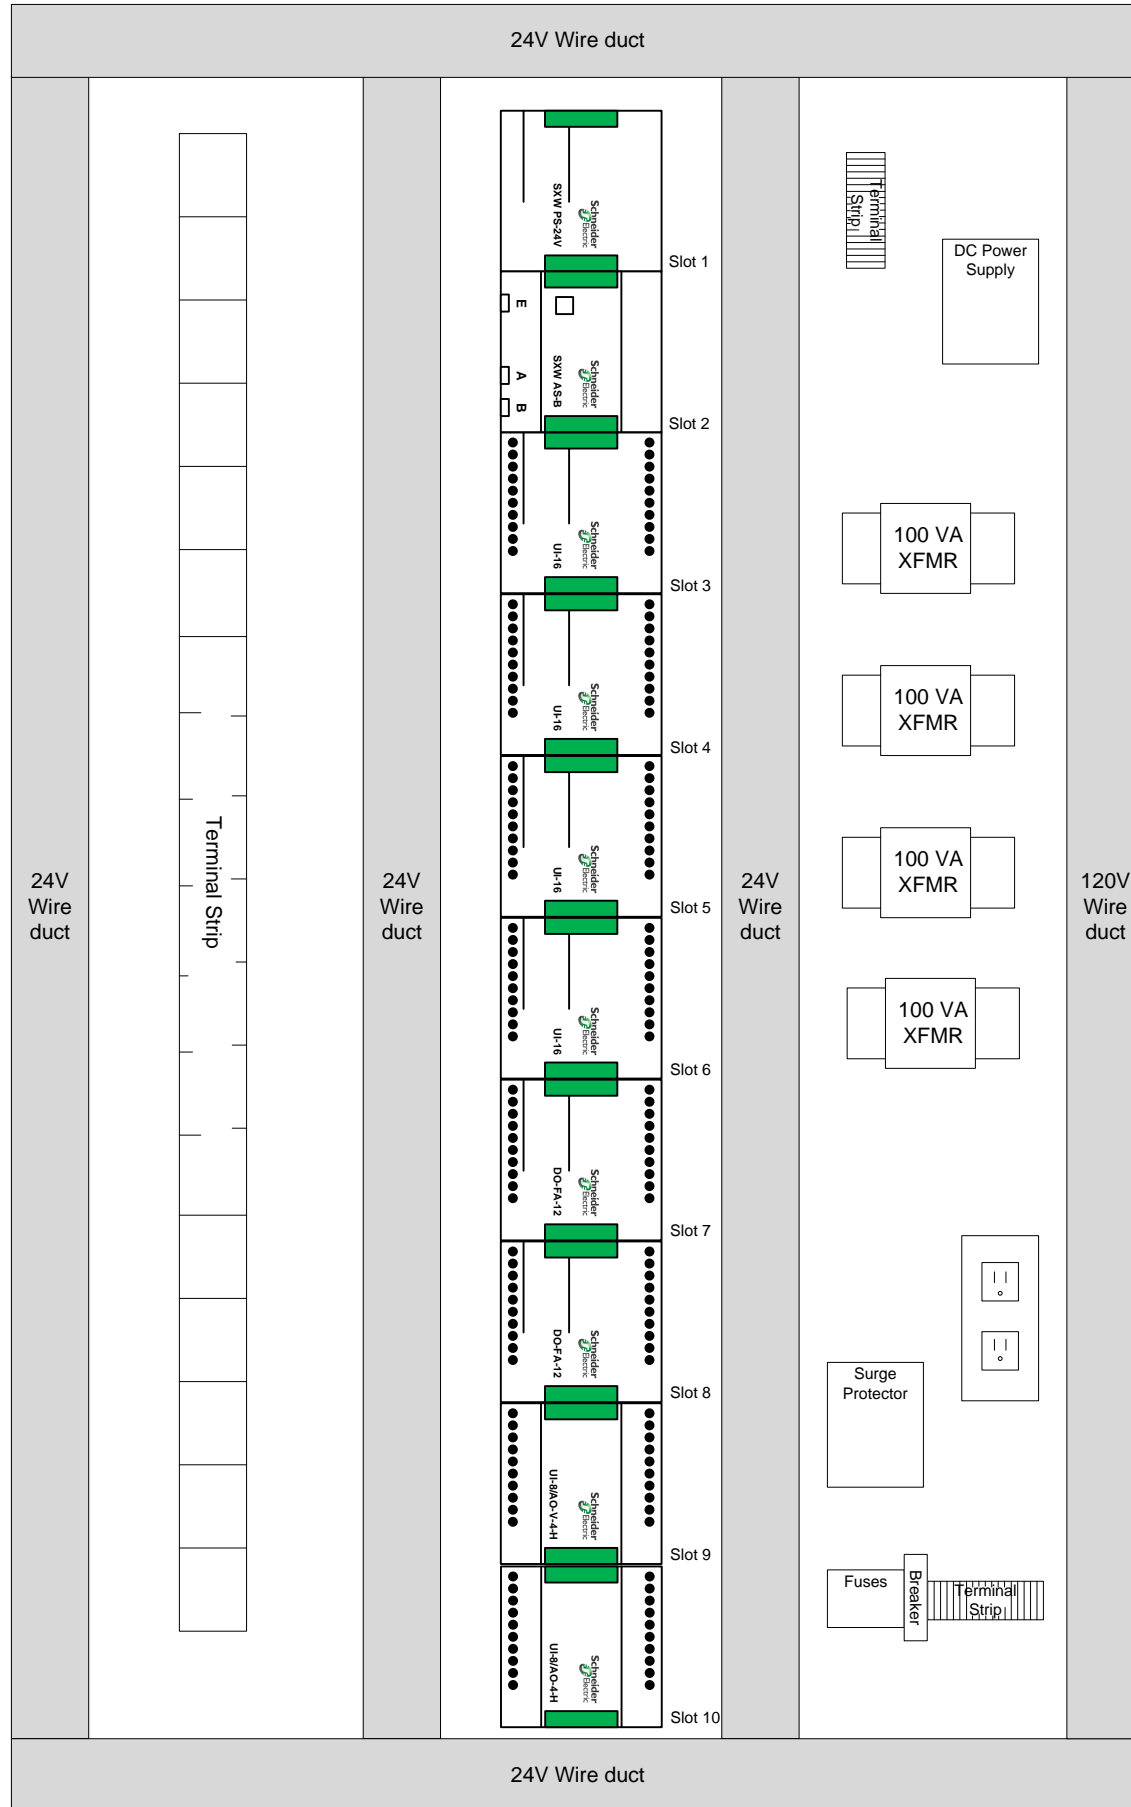

Bill of Materials			
Manufacturer	Description	Part Number	Quantity
Kele	Wet Differential Pressure Sensor	PSS2-100	6
Mamac	Immersion Temperature Probe	TE-703-C-7-A-1	4
Veris	75VA Transformer	X075CBA	1
Veris	96VA Transformer	X100CBA	1
Veris	Current Sensor	VER-H300	4
Schneider Electric	Power Supply	SXW-PS-24V	1
Schneider Electric	Automation Servers	SXW AS-B	1
Schneider Electric	Input Module	SXW UI-16	1
APAC	Duct Smoke Detector	L-364-P	4
Mamac	Duct Temperature Sensor	TE-702-B-7-D	5
Mamac	Immersion Temperature Probe	TE-703-C-7-A-1	6
MAMAC	Duct Temperature Sensor	TE-702-B-7-D	2
TAC	Room Temperature Sensor	ETR503	8
TAC	Wet Differential Pressure Sensor	EPP102-LCD	6
Veris	96VA Transformer	X100CBA	2
Veris	Current Sensor	VER-H300	9
Schneider Electric	Input Module	SXW UI-16	3
APAC	SPDT Relay	P-PAM-1	9
Schneider Electric	Dry Differential Pressure Sensor	EPP 102	1
TAC	Damper Actuator	MA40-7043	2
TAC	Valve Actuator	BB3N06+M113A00	1
Veris	96VA Transformer	X100CBA	1
Veris	SPDT Relay	V100	7
Schneider Electric	Output Module	SXW DO-FA-12	1
Schneider Electric	Output Module	SXW DO-FC-8	1
Schneider Electric	Output/Input Module	SXW UI-8/AO-4	1
Schneider Electric	Outside Air Temp	EH0110-500-1	1

HVAC/Controls
Security/Access Controls
Service and Monitoring

BIAC



PROJECT: NASA INFRARED TELESCOPE FACILITY

DRAWING TITLE: ATC PANEL LAYOUT

REVISIONS:

DRAWN BY: AG

ENG. BY: JL


CHK'D BY: JL

DATE: 8-13-13

JOB NO.

DWG NO. TC-3 of 14

As Built

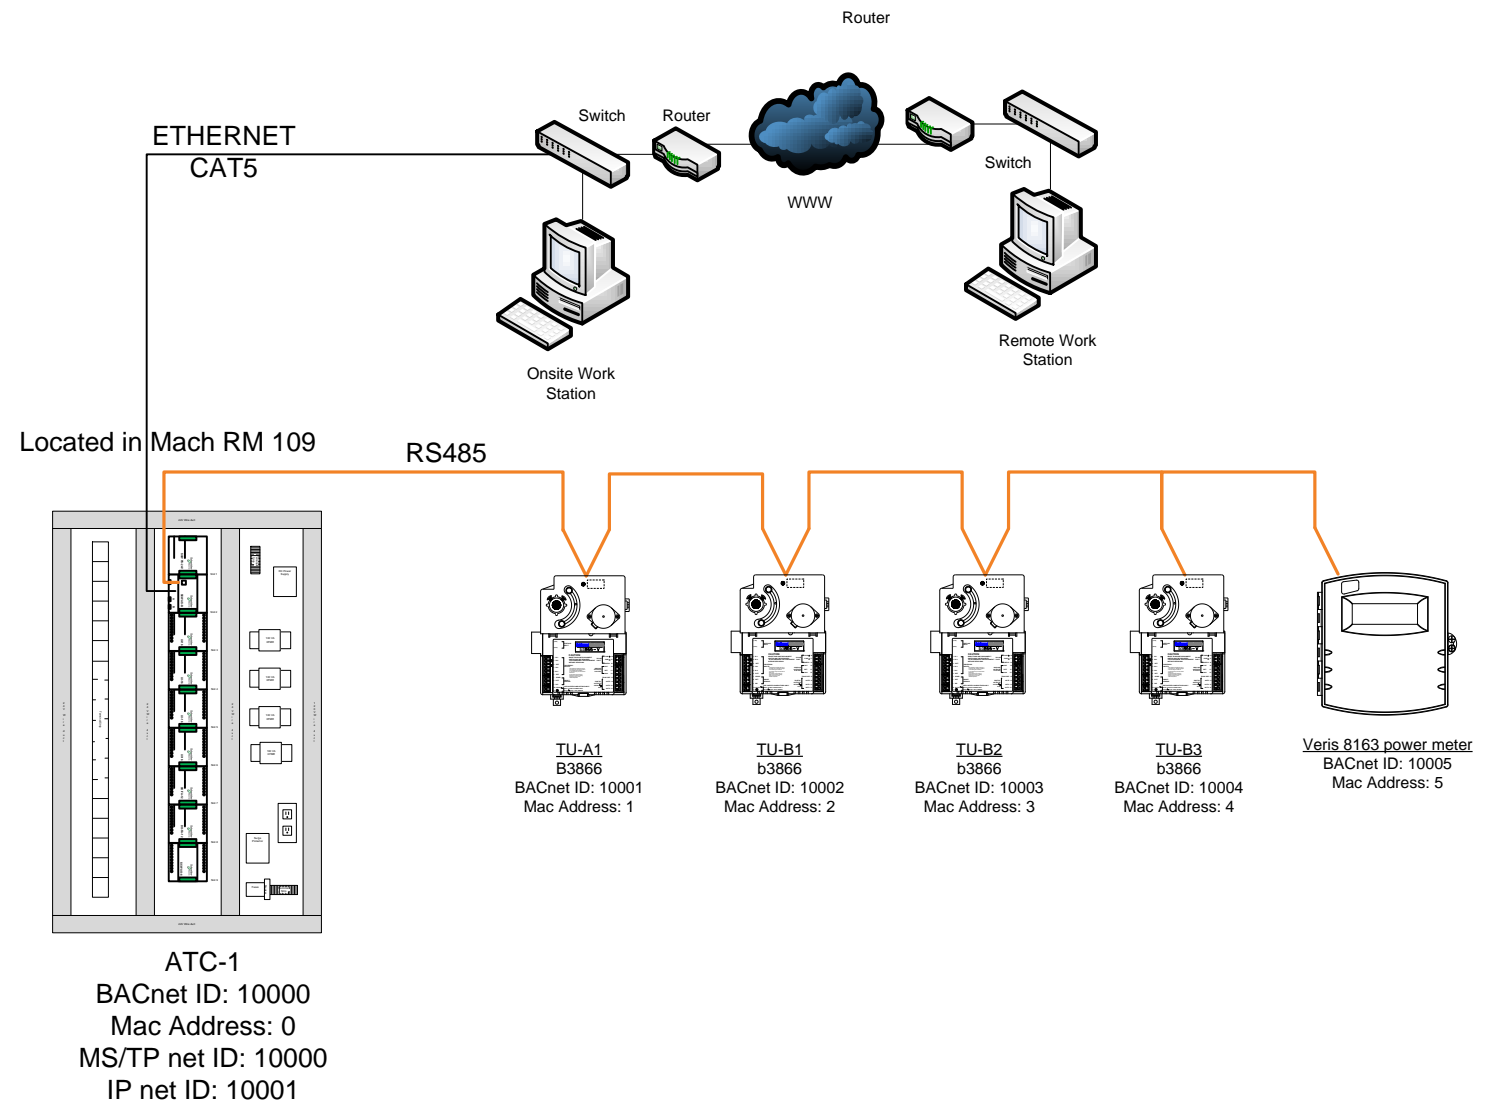

Bill of Materials			
Manufacturer	Description	Part Number	Quantity
Schneider Electric	Power Supply	SXW PS-24V	1
Schneider Electric	Automation Servers	SXW AS-B	1
Schneider Electric	Input Module	SXW UI-16	2
Schneider Electric	Output Module	SXW DO-FA-12	1
Schneider Electric	Output Module	SXW DO-FC-8	1
Schneider Electric	Output/Input Module	SXW UI-8/AO-4	1
Andover	TU Controller	b3866-V	4

HVAC/Controls
 Security/Access Controls
 Service and Monitoring

BIAC



PROJECT: NASA INFRARED TELESCOPE FACILITY

DRAWING TITLE: SYSTEM ARCHITECTURE

REVISIONS:

DRAWN BY: AG

ENG. BY: JL

CHK'D BY: JL







DATE: 8-13-13

JOB NO.

DWG NO. TC-4 of 14

As Built

Bill of Materials			
Manufacturer	Description	Part Number	Quantity
Kele	Wet Differential Pressure Sensor	PSS2-100	6
Mamac	Immersion Temperature Probe	TE-703-C-7-A-2	4
Veris	75VA Transformer	X075CBA	1
Veris	96VA Transformer	X100CBA	1
Veris	Current Sensor	VER-H300	4
Schneider Electric	Power Supply	SXW-PS-24V	1
Schneider Electric	Automation Servers	SXW AS-B	1
Schneider Electric	Input Module	SXW UI-16	1

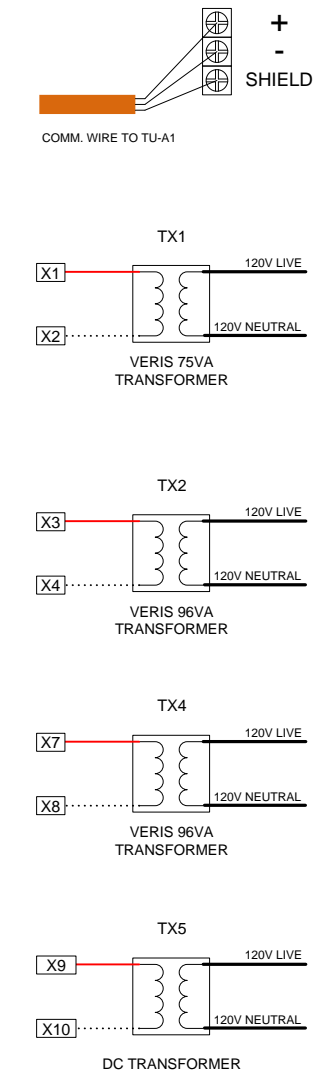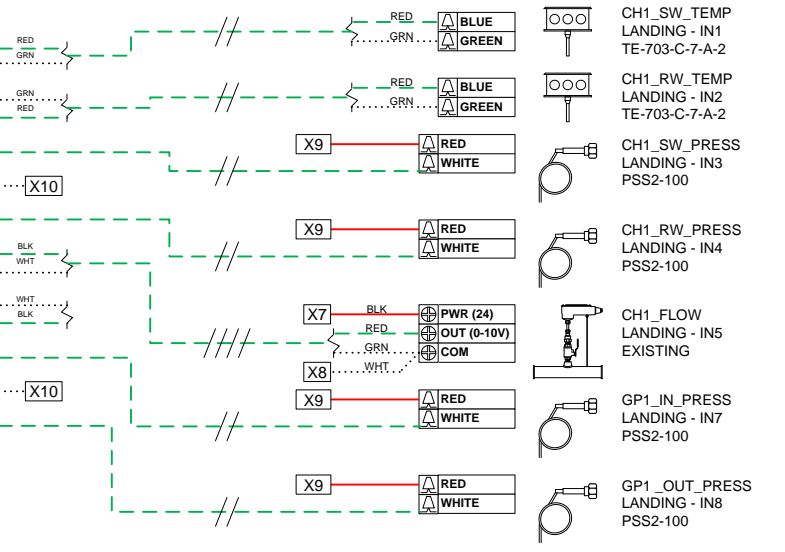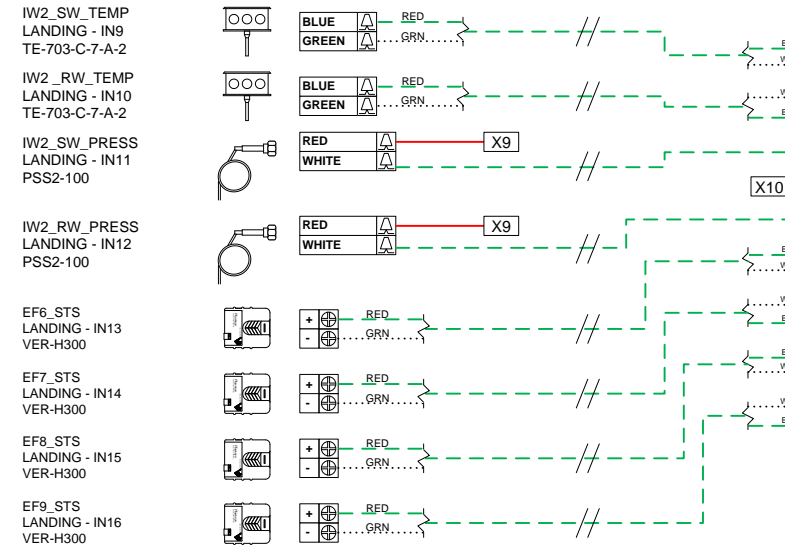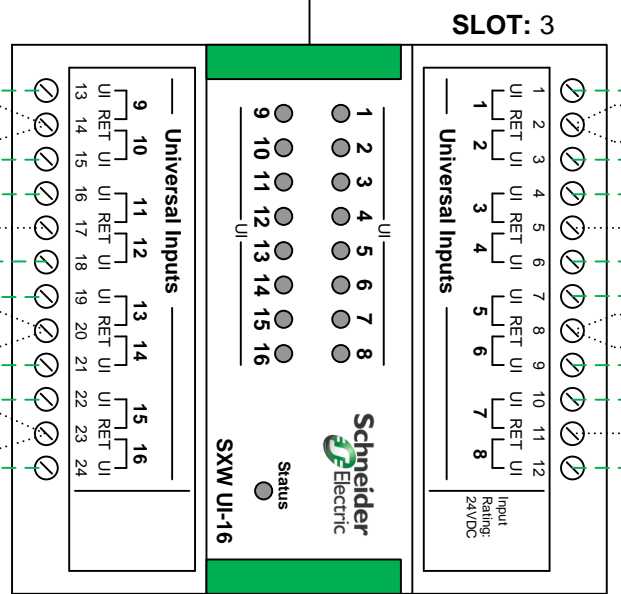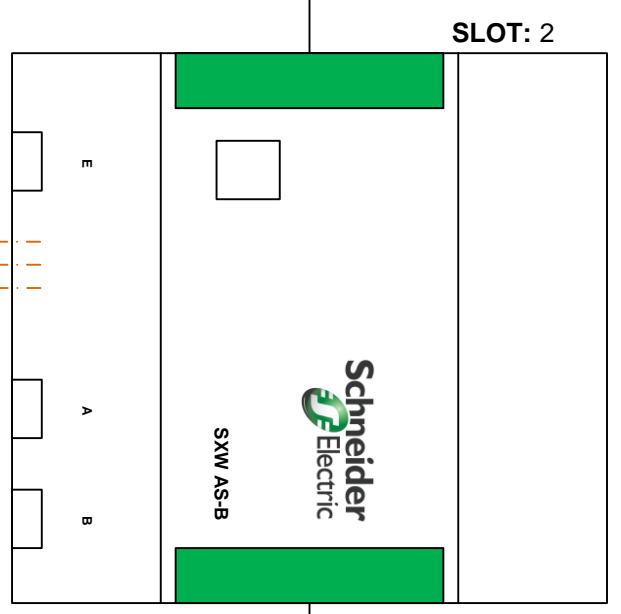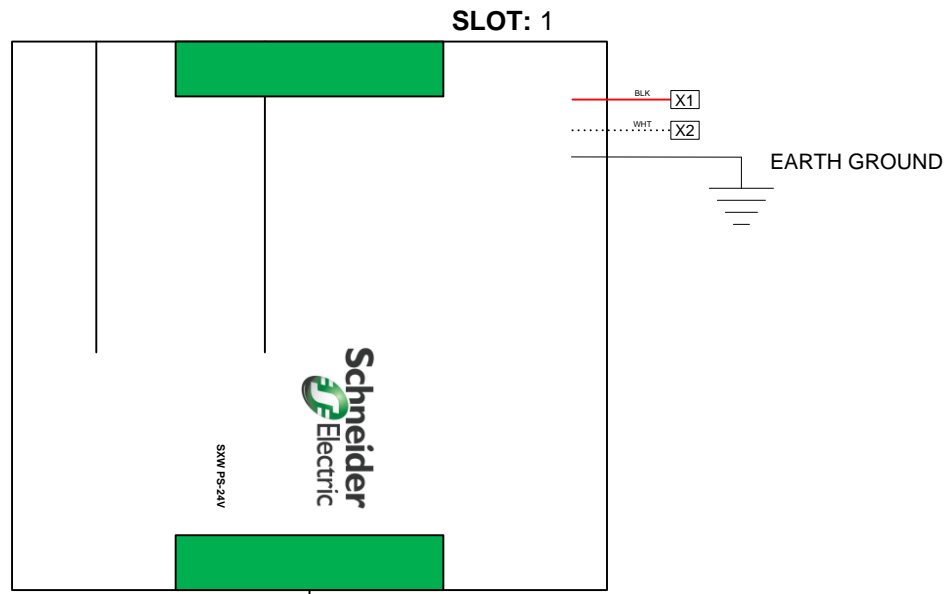

HVAC/Controls
Security/Access Controls
Service and Monitoring

BIAC



PROJECT: **NASA INFRARED TELESCOPE FACILITY**

DRAWING TITLE: **ATC SLOTS 1-3**

REVISIONS:

DRAWN BY: **AG**

ENG. BY: **JL**

CHK'D BY: **JL**

DATE: **8-13-13**




JOB NO.

DWG NO. **TC-5 of 14**

Continued on page TC-6

As Built

Continued from page TC-5

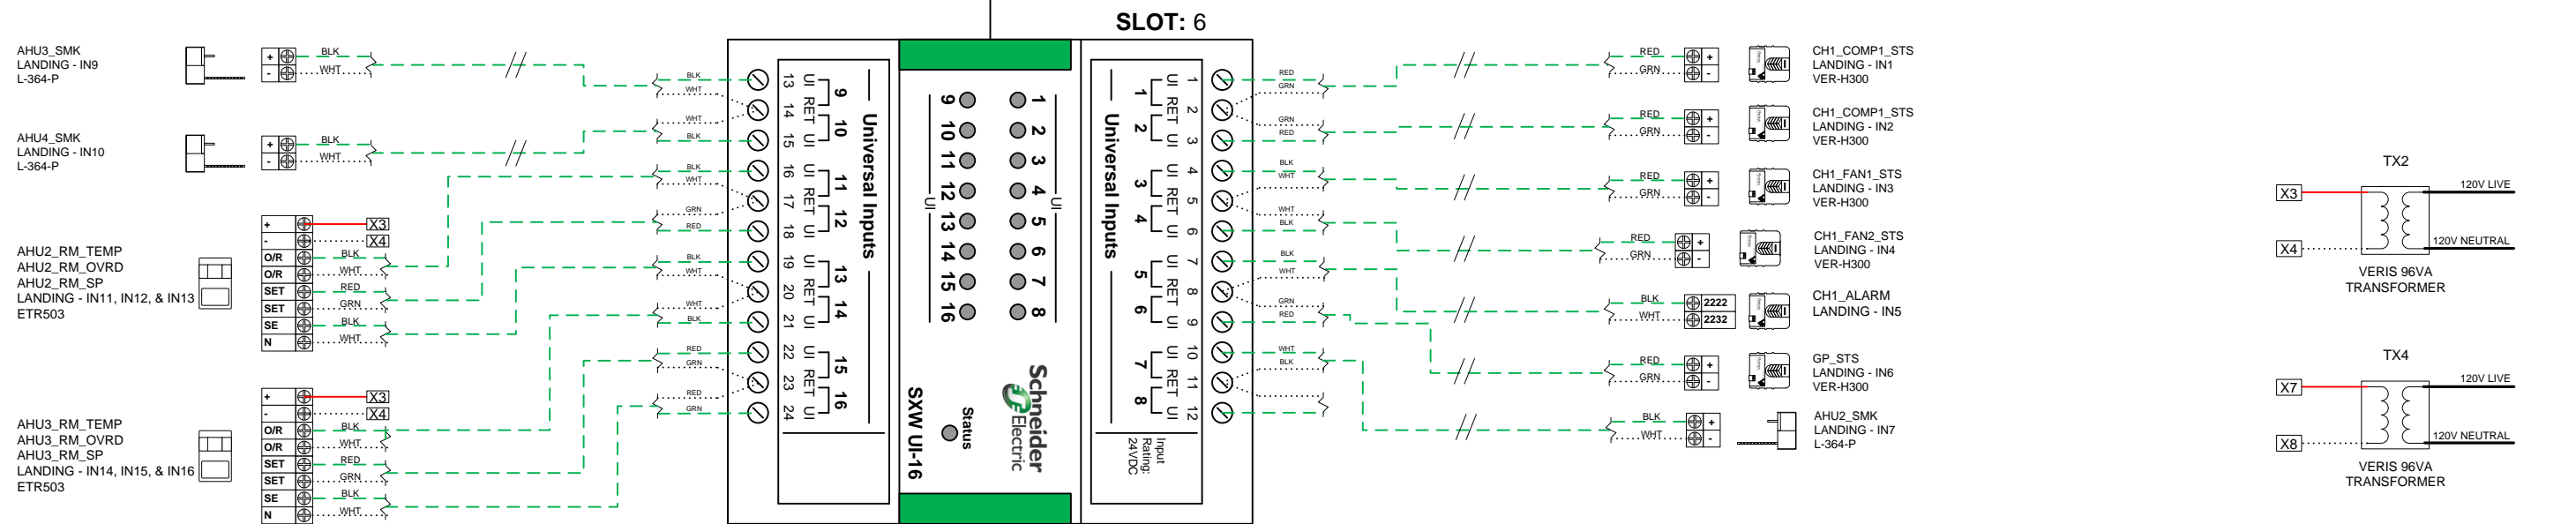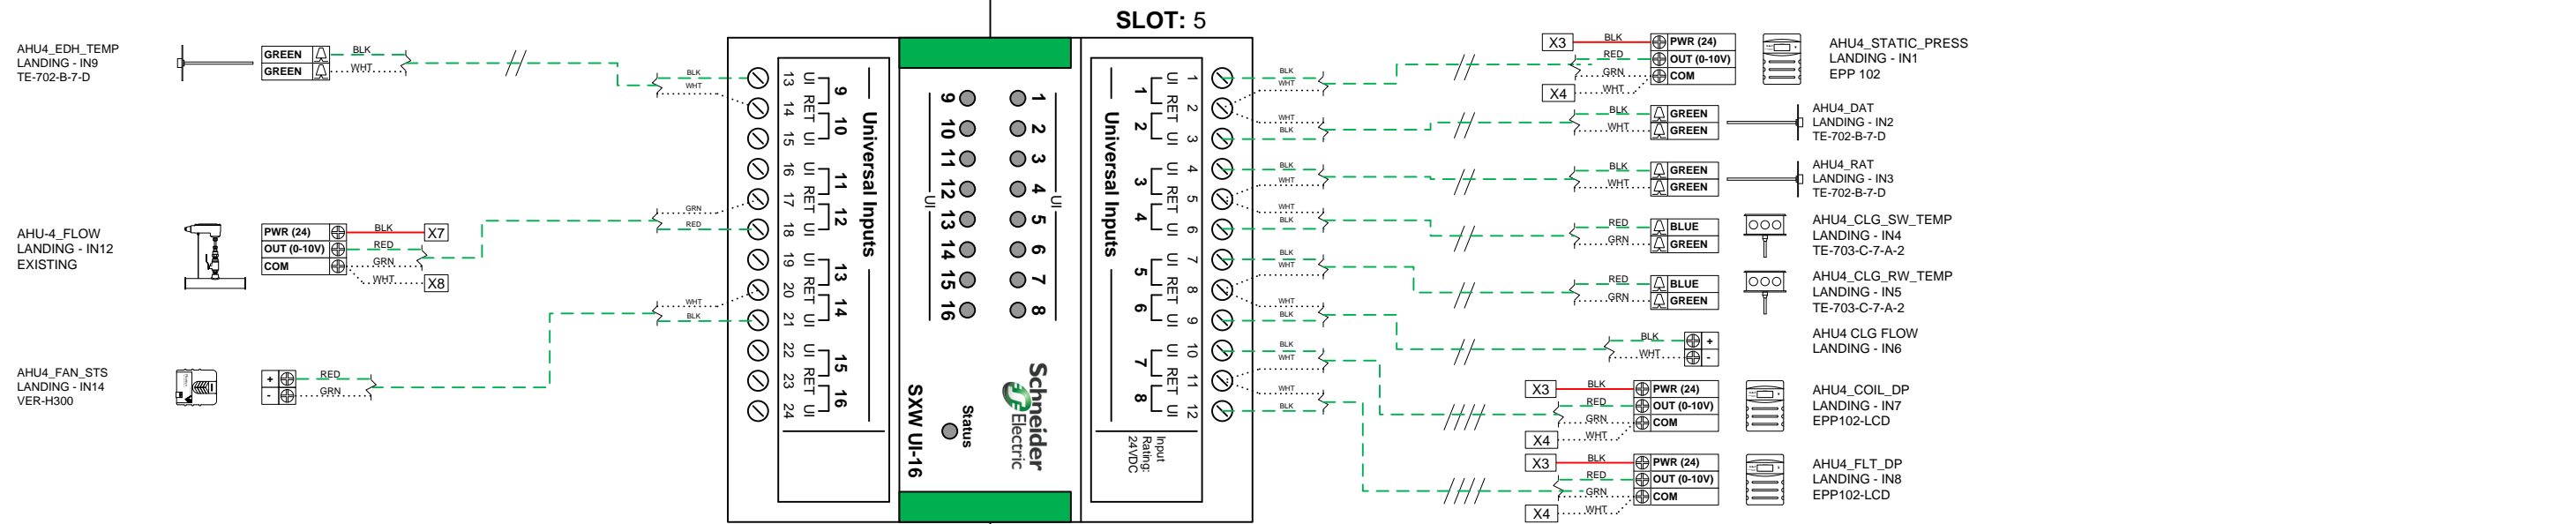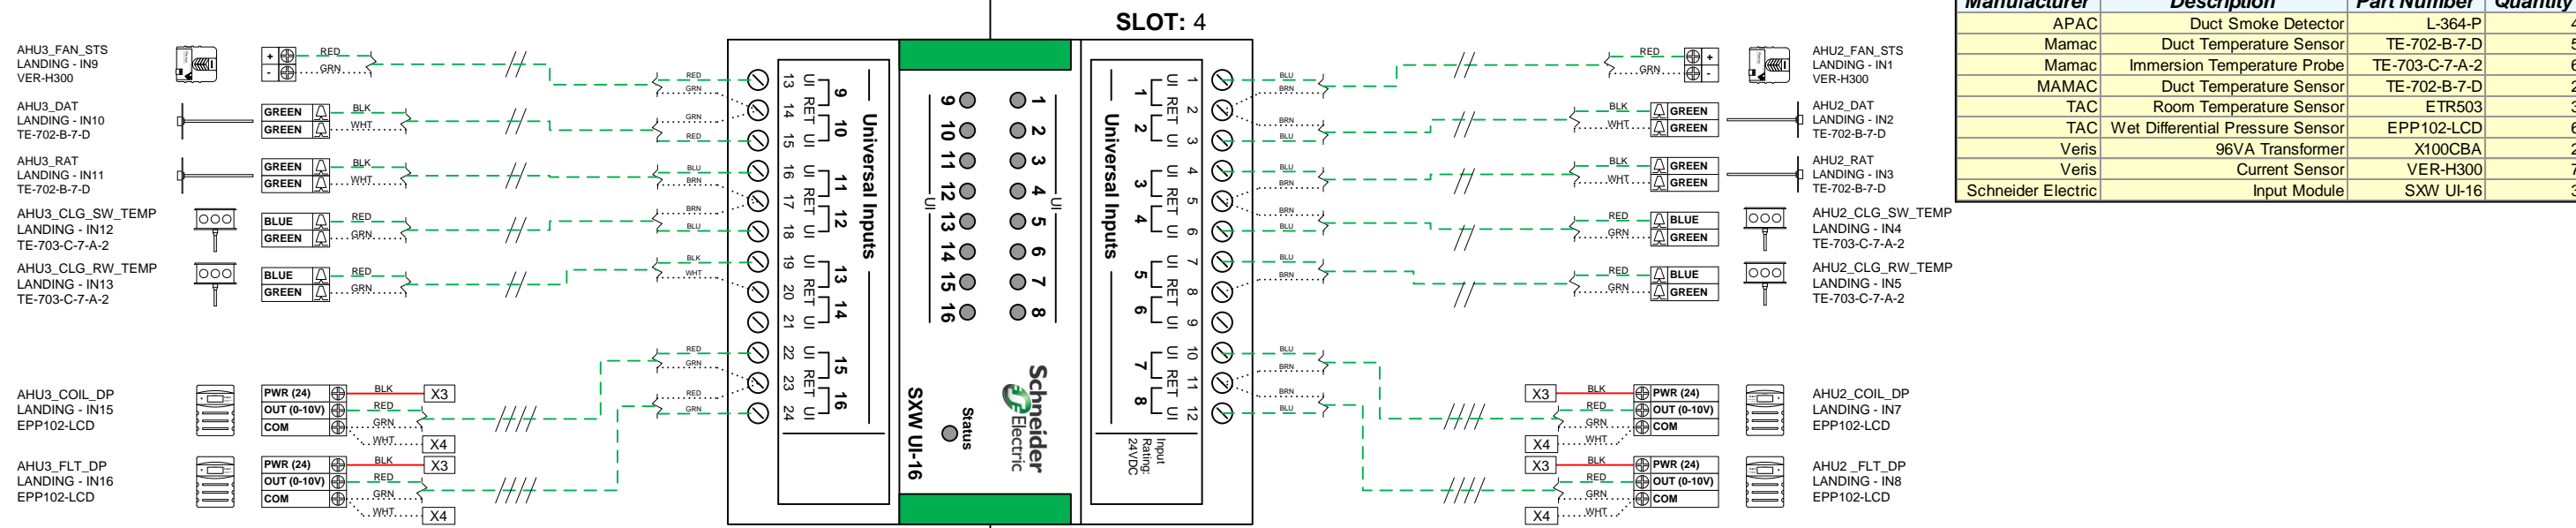

Continued on page TC-7

Bill of Materials			
Manufacturer	Description	Part Number	Quantity
APAC	Duct Smoke Detector	L-364-P	4
Mamac	Duct Temperature Sensor	TE-702-B-7-D	5
Mamac	Immersion Temperature Probe	TE-703-C-7-A-2	6
MAMAC	Duct Temperature Sensor	TE-702-B-7-D	2
TAC	Room Temperature Sensor	ETR503	3
TAC	Wet Differential Pressure Sensor	EPP102-LCD	6
Veris	96VA Transformer	X100CBA	2
Veris	Current Sensor	VER-H300	7
Schneider Electric	Input Module	SXW UI-16	3

HVAC/Controls
Security/Access Controls
Service and Monitoring

BIAC



PROJECT: NASA INFRARED TELESCOPE FACILITY

ATC SLOTS 4-6

REVISIONS:

DRAWN BY: AG


ENG. BY: JL

CHK'D BY: JL

DATE: 8-13-13

JOB NO.


DWG NO. TC-6 of 14

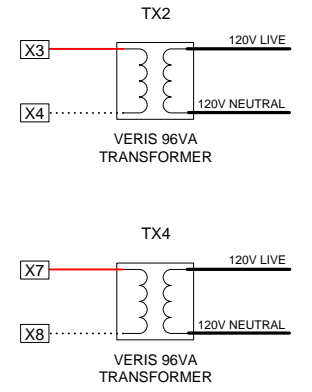

As Built


Continued from page TC-6

AHU4_FAN_CMD
LANDING - OUT7

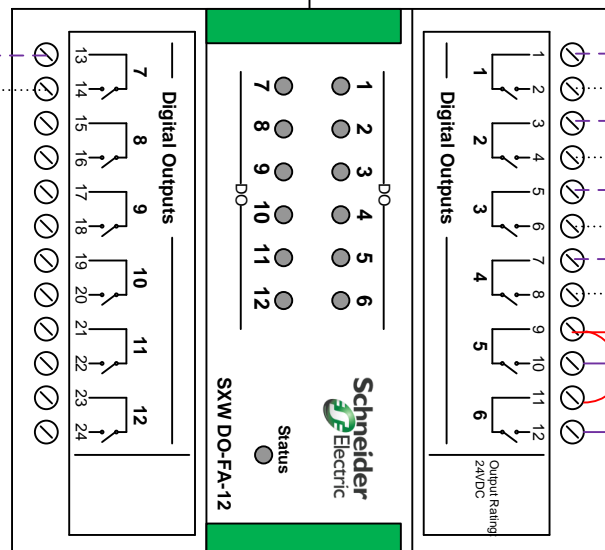


SLOT: 7


EF6_CMD
LANDING - OUT1

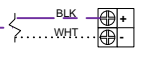


EF7_CMD
LANDING - OUT2

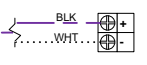


EF8_CMD
LANDING - OUT3

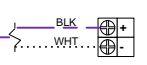

EF9_CMD
LANDING - OUT4

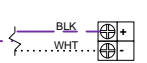

AHU4_EDH_STG1_CMD
LANDING - OUT5
V100


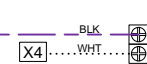


AHU4_EDH_STG2_CMD
LANDING - OUT6
V100




Bill of Materials			
Manufacturer	Description	Part Number	Quantity
APAC	SPDT Relay	P-PAM-1	9
Schneider Electric	Dry Differential Pressure Sensor	EPP 102	1
TAC	Damper Actuator	MA40-7043	2
TAC	Valve Actuator	VBB3N06+M113A00	1
Veris	96VA Transformer	X100CBA	1
Veris	Room Temperature Sensor	ETR503	1
Veris	SPDT Relay	V100	7
Schneider Electric	Output Module	SXW DO-FA-12	1
Schneider Electric	Output Module	SXW DO-FC-8	1
Schneider Electric	Output/Input Module	SXW UI-8/AO-4	1
Schneider Electric	Outside Air Temp Sensor	EH0110-500-1	1

AHU4_RA_DMPR
LANDING - OUT5
MA40-7043

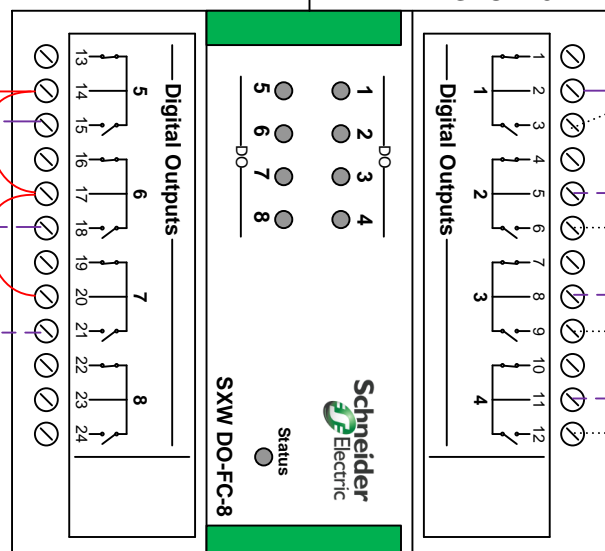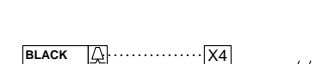


SLOT: 8


CH1_CMD
LANDING - OUT1

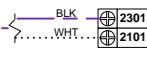


GP1_CMD
LANDING - OUT2

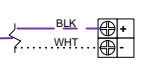

AHU2_FAN_CMD
LANDING - OUT3

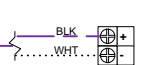

AHU3_FAN_CMD
LANDING - OUT4

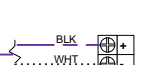


AHU4_DEFROST_DMPR
LANDING - OUT6
MA40-7043



AHU4_SA_DMPR
LANDING - OUT7
MA40-7043




OSA_TEMP
LANDING - IN1
EH0110-500

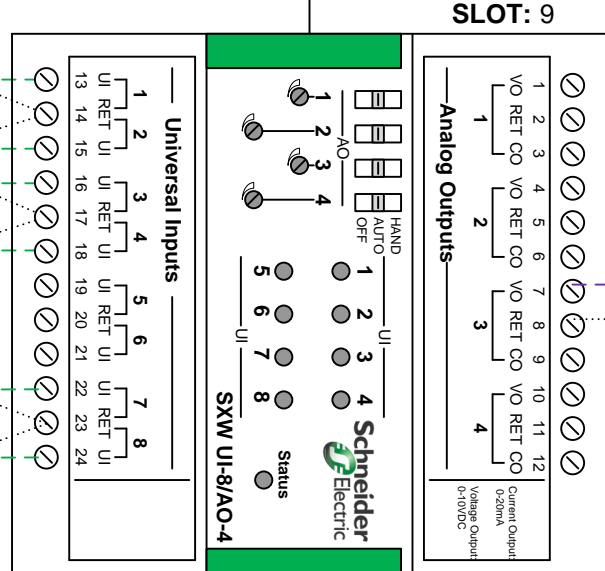


SLOT: 9

AHU4_CLG_VLV
LANDING - OUT3
VBB3N07+M113A00

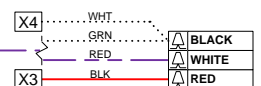

AHU4_RM_TEMP
AHU4_RM_OVRD
AHU4_RM_SP
LANDING - IN2, IN3 & IN4
ETR503

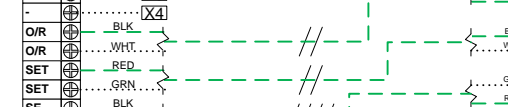

IW1_STS
LANDING - IN7
VER-H300



IW2_STS
LANDING - IN8
VER-H300



Continued on page TC-8

HVAC/Controls
Security/Access Controls
Service and Monitoring

BIAC



PROJECT: NASA INFRARED TELESCOPE FACILITY

DRAWING TITLE: ATC SLOTS 7-9

REVISIONS:

DRAWN BY: AG


ENG. BY: JL

CHK'D BY: JL

DATE: 8-13-13

JOB NO.

DWG NO. TC-7 of 14

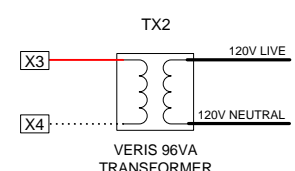

As Built


Continued from page TC-7

SLOT: 10

COND_FAN_1_SPD
LANDING - IN1
VFD TERMINAL STRIP 8, 9

COND_FAN_2_SPD
LANDING - IN2
VFD TERMINAL STRIP 8, 9

OSA_HUM
LANDING - IN3
EDH-500

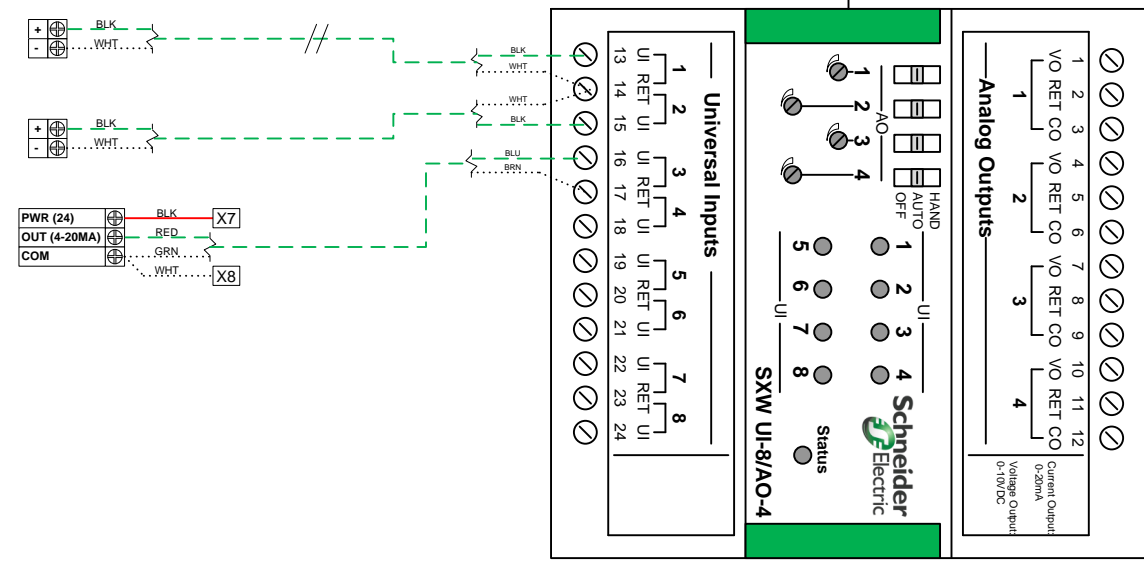

Bill of Materials			
Manufacturer	Description	Part Number	Quantity
Schneider Electric	IO Module	UI-8/AO-4	1

HVAC/Controls
Security/Access Controls
Service and Monitoring

BIAC



PROJECT: NASA INFRARED TELESCOPE FACILITY

DRAWING TITLE: ATC SLOT 10

REVISIONS:

DRAWN BY: AG

ENG. BY: JL



CHK'D BY: JL

DATE: 8-13-13


JOB NO.

DWG NO. TC-8 of 14

As Built

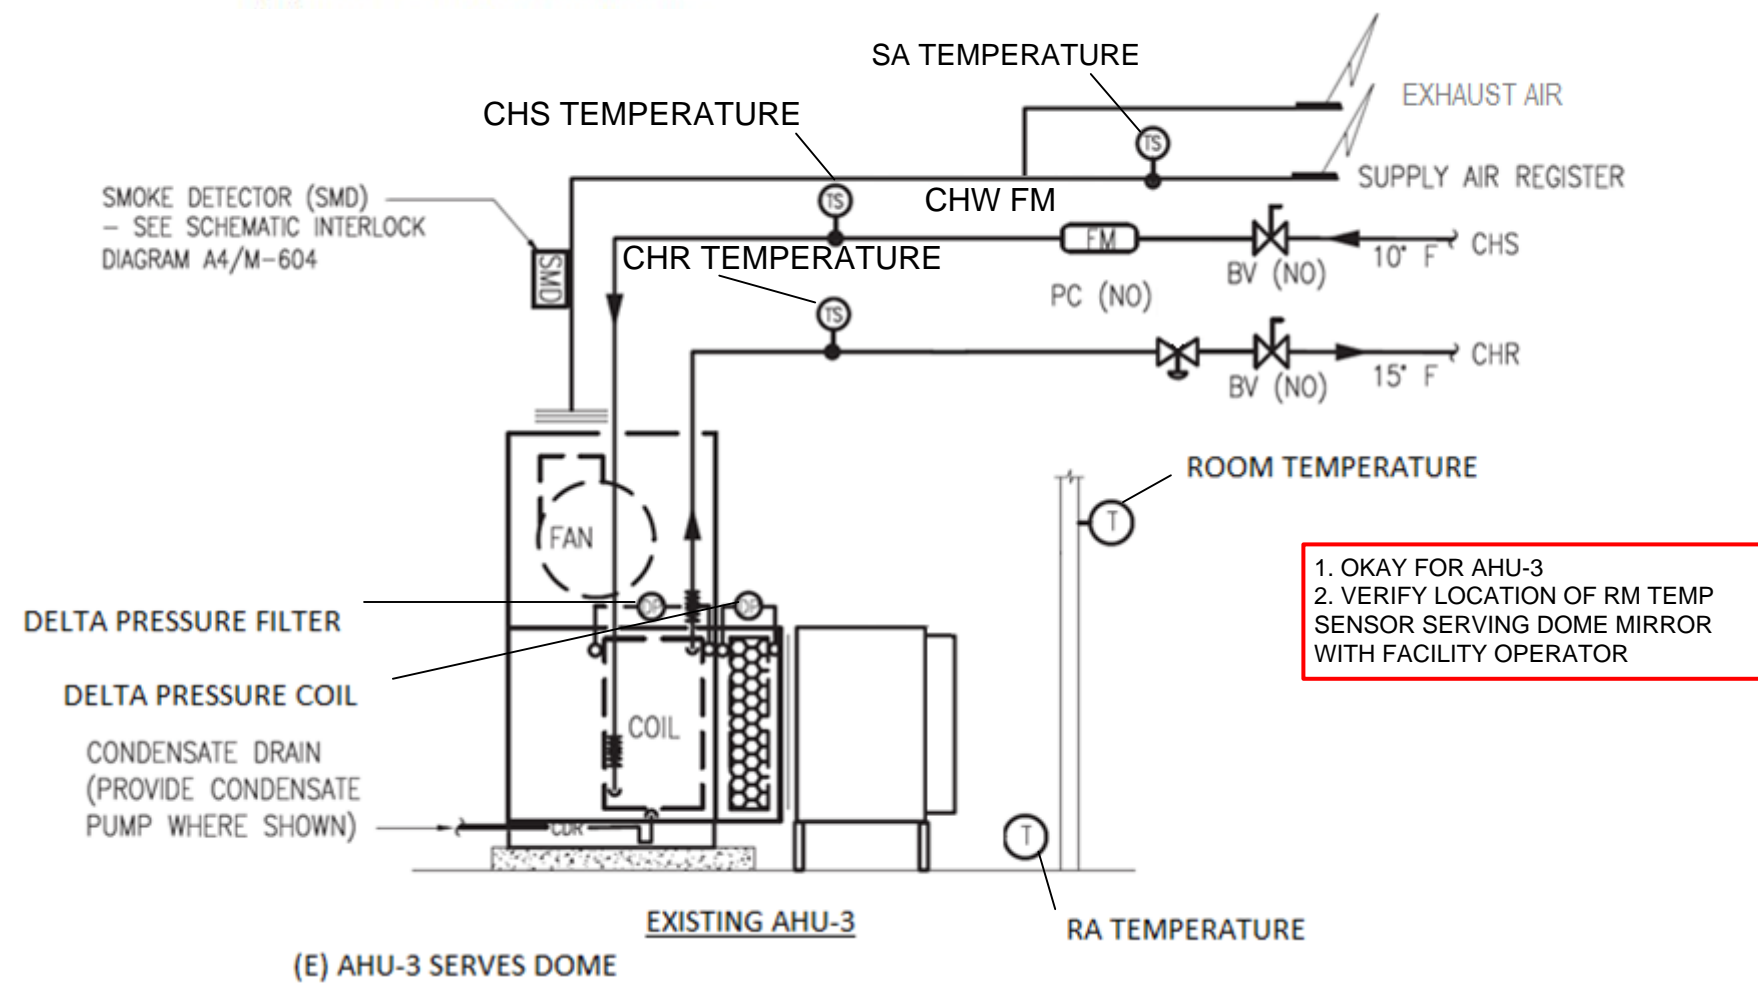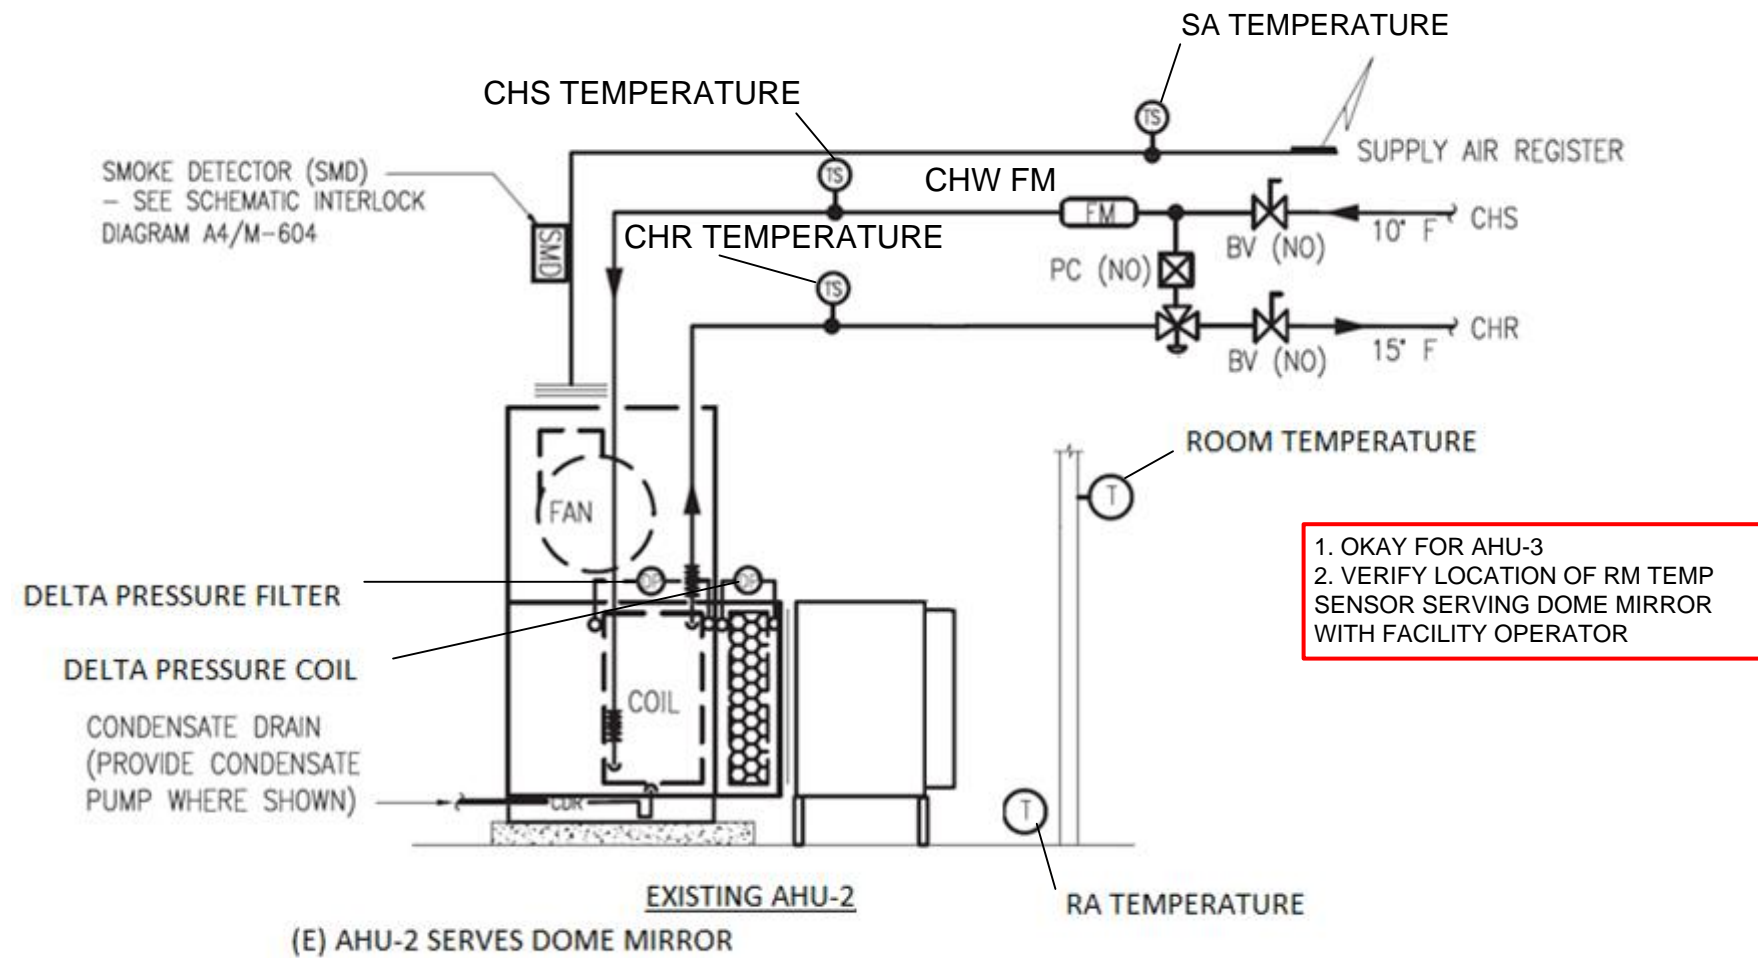

As Built

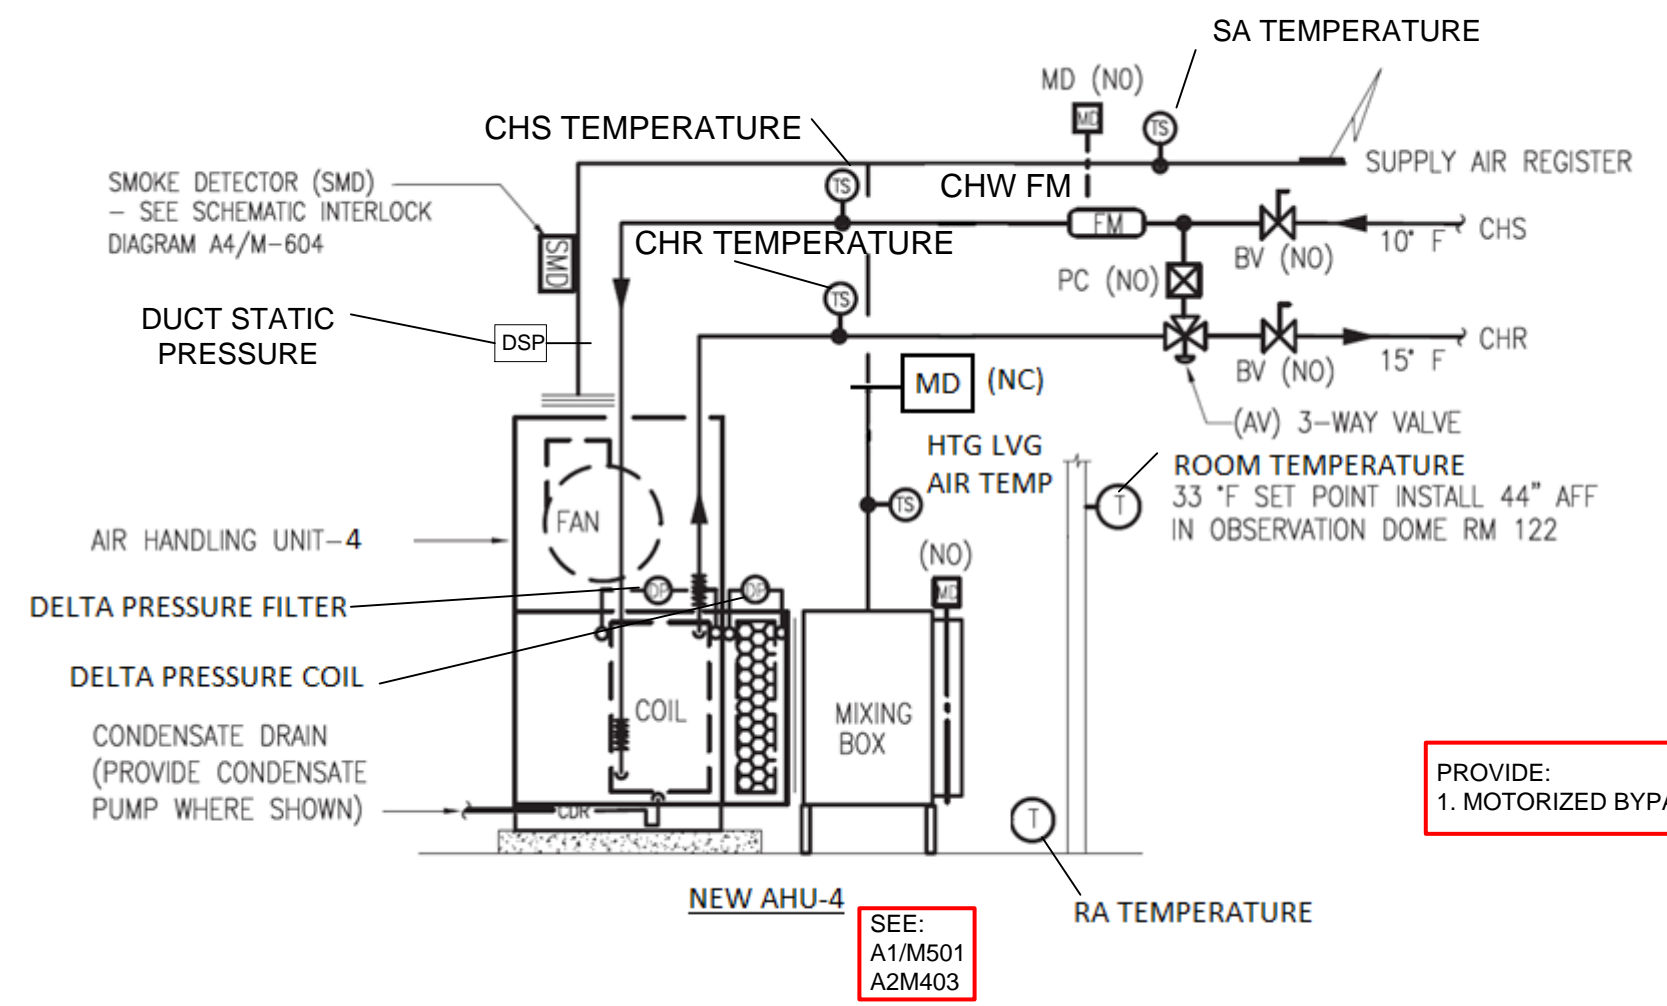

PROVIDE:
1. MOTORIZED BYPASS DAMPER

SEE:
A1/M501
A2M403

PROJECT: NASA INFRARED TELESCOPE FACILITY

DRAWING TITLE: ATC EQUIPMENT B

REVISIONS:

DRAWN BY: AG

ENG. BY: JL


CHK'D BY: JL

DATE: 8-13-13

JOB NO.

DWG NO. TC-10 of 14


As Built

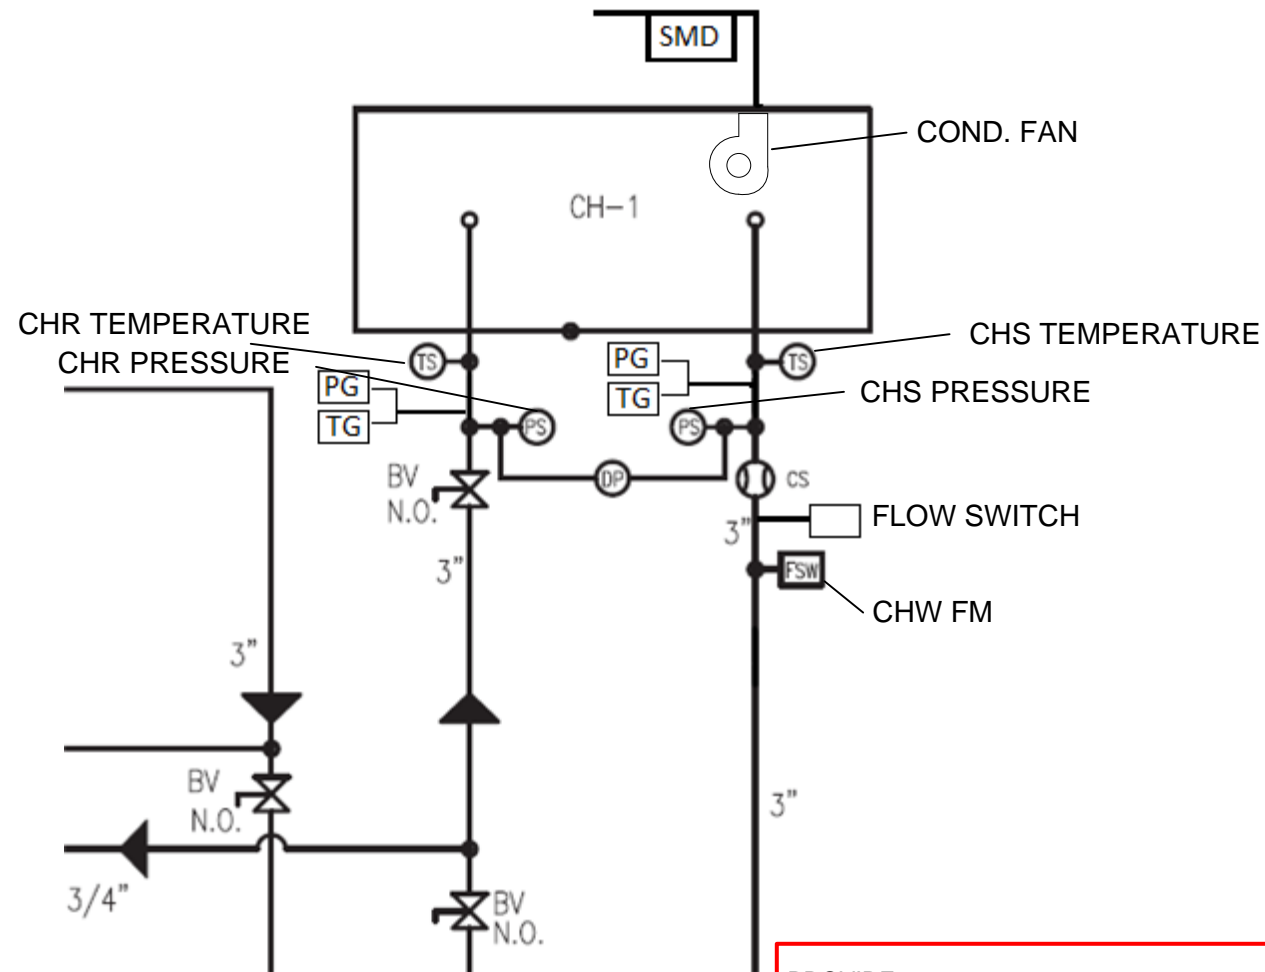

CH-1


PROVIDE:
1. CHS TEMP RESET

SEE:
A1/M604
B4/M501

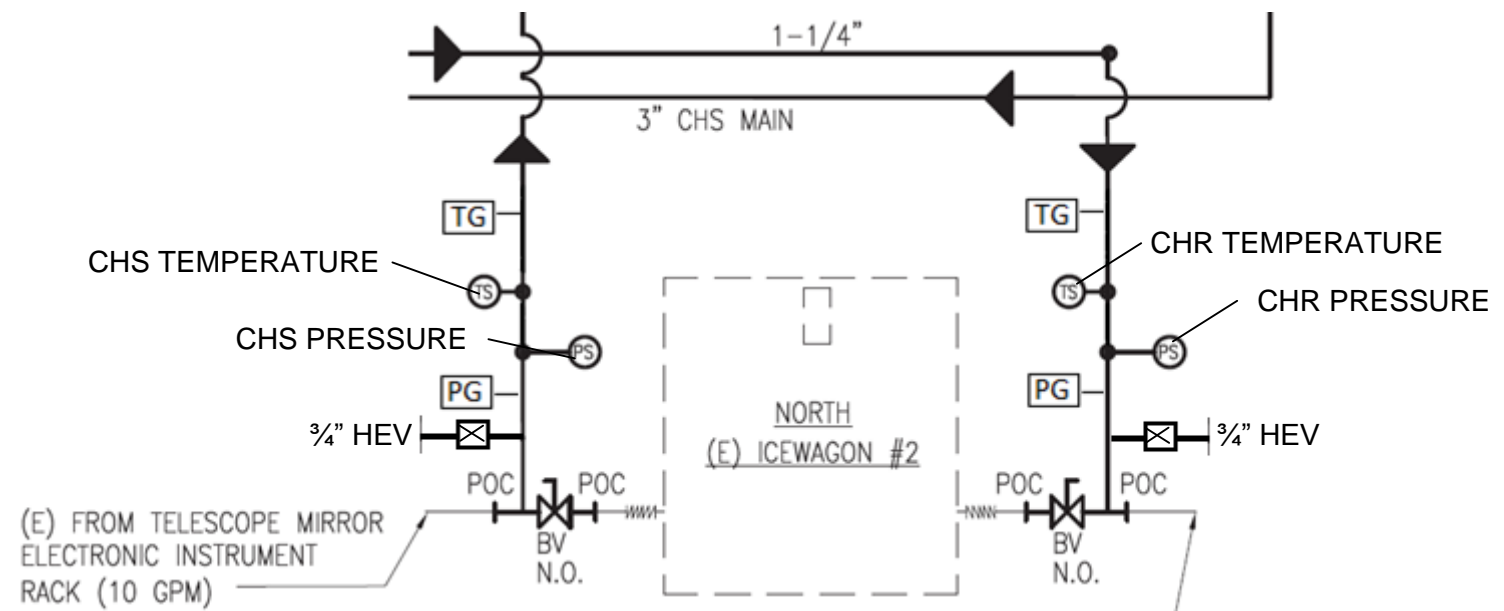


ICE WAGON-2

SEE:
A1/M604
A2/M603

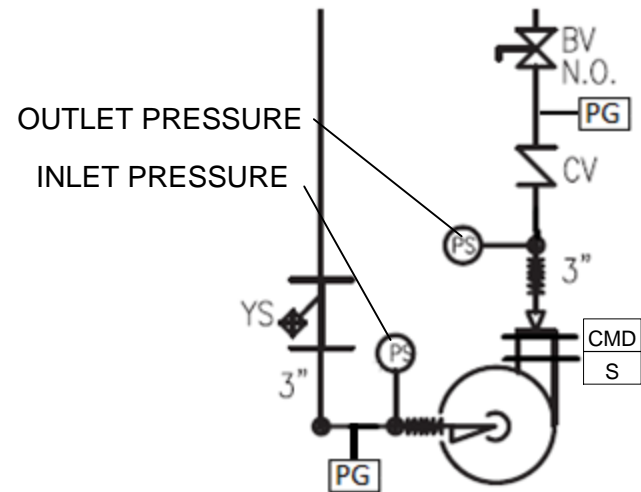


GP-1

SEE:
A1/M604
A2/M603

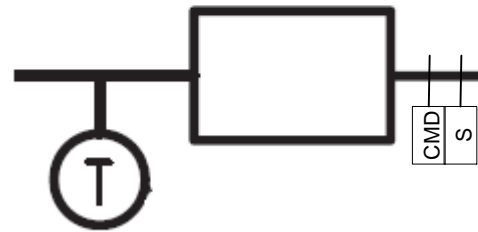

EF-6, 7, 8, 9

PROVIDE
1. MOTORIZED
DAMPERS FOR EF-9
SEE A2/M402, A4/M604,
C3/M301

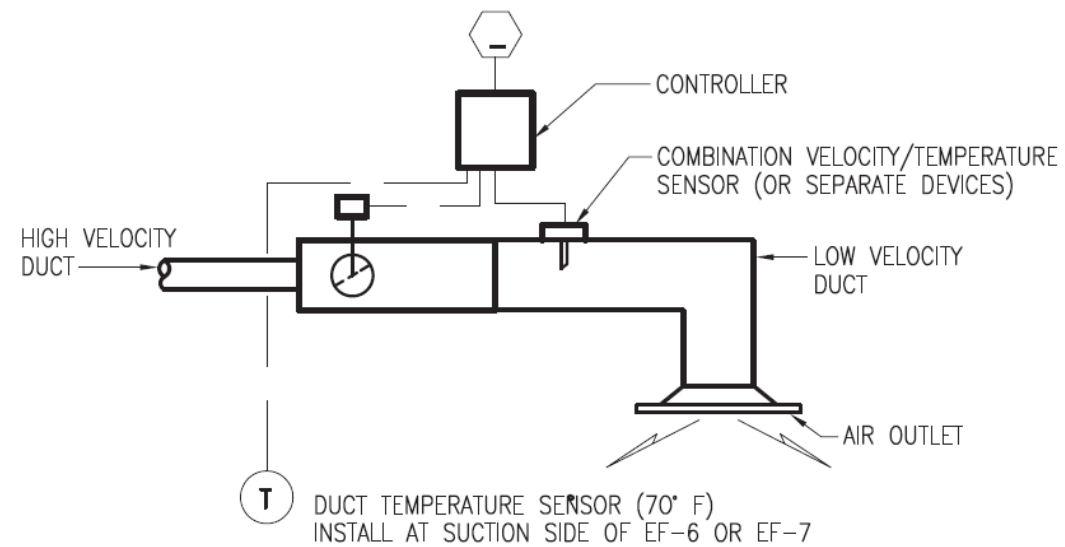

TU-A1, B1, B2, B3

As Built

PROJECT:

REVISIONS:

NO.	DESCRIPTION

DRAWN BY: AG

ENG. BY: JL

CHK'D BY: JL

DATE: 8-13-13

JOB NO.

DWG NO. TC-11 of 14

Bill of Materials			
Manufacturer	Description	Part Number	Quantity
Andover	Controller	b3866-V	1
MAMAC	Duct Temperature Sensor	TE-702-B-7-D	2
Veris	96VA Transformer	X100CAB	1

HVAC/Controls
Security/Access Controls
Service and Monitoring

BIAC



PROJECT: NASA INFRARED TELESCOPE FACILITY



DRAWING TITLE: TU-A1 & TU-B1

REVISIONS:



DRAWN BY: AG
 ENG. BY: JL
 CHK'D BY: JL
 DATE: 8-13-13
 JOB NO.
 DWG NO. TC-12 of 14

TU-B2 & TU-B3
 TO BE CONTROLLED BY DDC AS LONG AS CHILLER IS ENABLED. DDC TO MONITOR AND TOTALIZE TU-B2 & TU-B3 CFM AND DEDUCT CHILLER-1 AND DISCHARGE EXCESS AIR THRU EXISTING LOUVER VIA TU-B2 & TU-B3

TU-B2 & TU-B3
 SEE A4/M602 PROVIDE
 1. CONTROLLER INFORMATION TO DDC #1-6
 2. COMMANDS ACCEPTED FROM DDC #1-3
 3. THE MIN CFM FOR TU-A1 & TU-B1 TO BE SET @ 30% OF DESIGN CFM

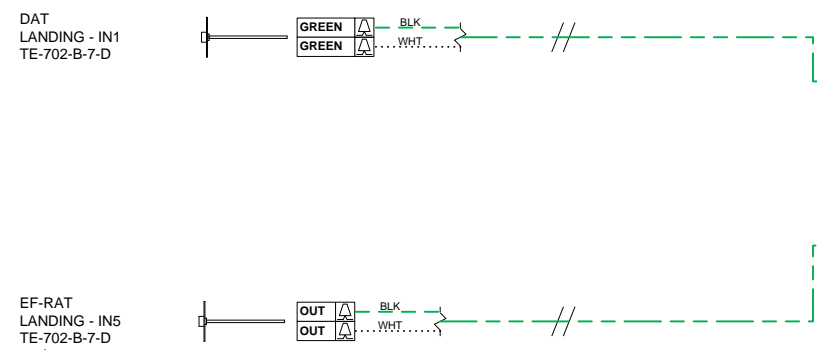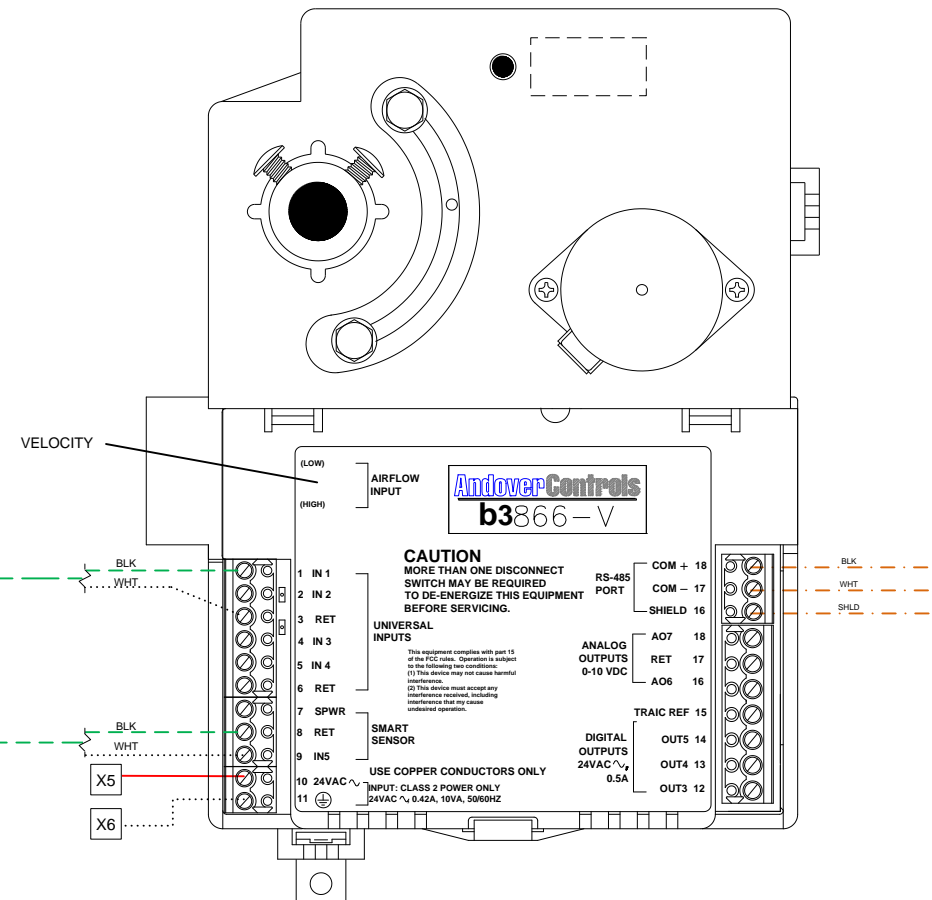

INSTALL AT SUCTION SIDE OF EF-6 & EF-7 SET @ 70°

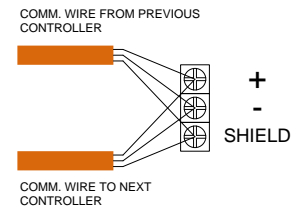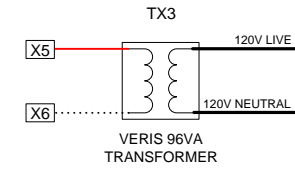

As Built

Bill of Materials			
Manufacturer	Description	Part Number	Quantity
Andover	Controller	b3866-V	1
MAMAC	Duct Temperature Sensor	TE-702-B-7-D	2
Veris	96VA Transformer	X100CAB	1

HVAC/Controls
Security/Access Controls
Service and Monitoring

BIAC



PROJECT: NASA INFRARED TELESCOPE FACILITY

DRAWING TITLE: TU-B2 & TU-B3

DRAWING TITLE: TU-B2 & TU-B3

REVISIONS:

DRAWN BY: AG

ENG. BY: JL



CHK'D BY: JL

DATE: 8-13-13

JOB NO.



DWG NO. TC-13 of 14

DAT LANDING - IN1
TE-702-B-7-D

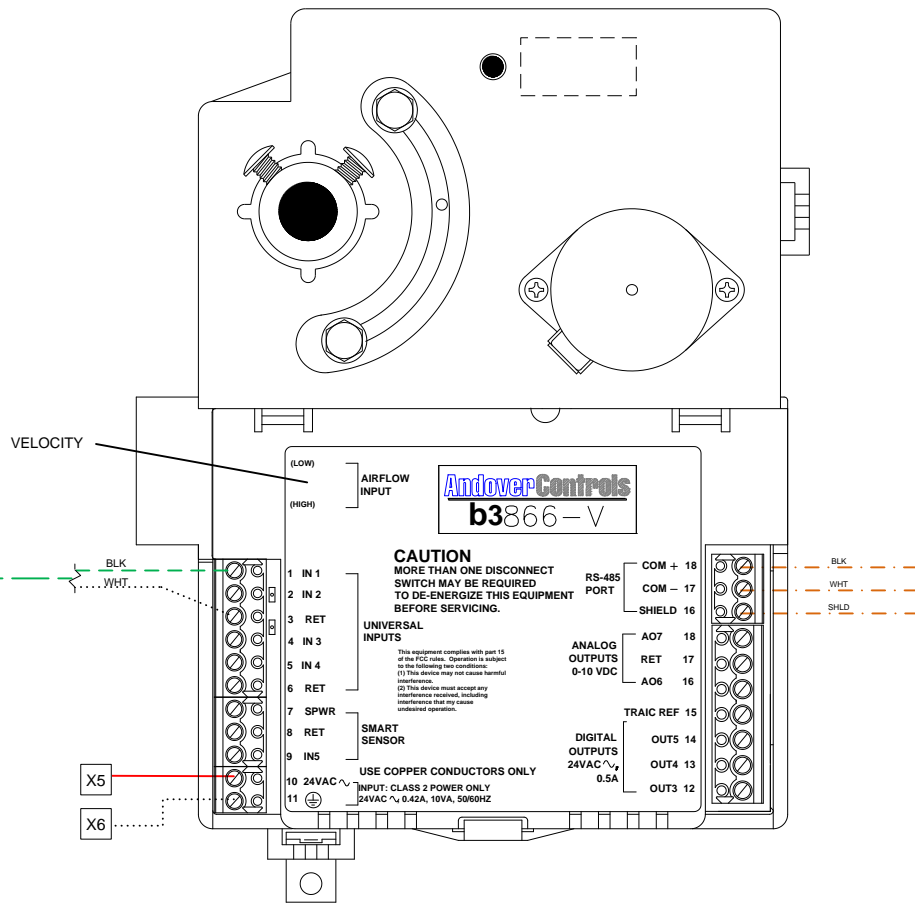
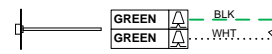


TU-B2 & TU-B3
TO BE CONTROLLED BY DDC AS LONG AS CHILLER IS ENABLED. DDC TO MONITOR AND TOTALIZE TU-B2 & TU-B3 CFM AND DEDUCT CHILLER-1 AND DISCHARGE EXCESS AIR THRU EXISTING LOUVER VIA TU-B2 & TU-B3


TU-B2 & TU-B3
SEE A4/M602 PROVIDE
1. CONTROLLER INFORMATION TO DDC #1-6
2. COMMANDS ACCEPTED FROM DDC #1-3
3. THE MIN CFM FOR TU-A1 & TU-B1 TO BE SET @ 30% OF DESIGN CFM

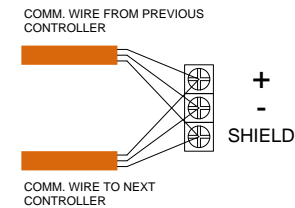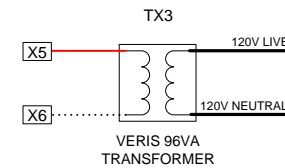

As Built

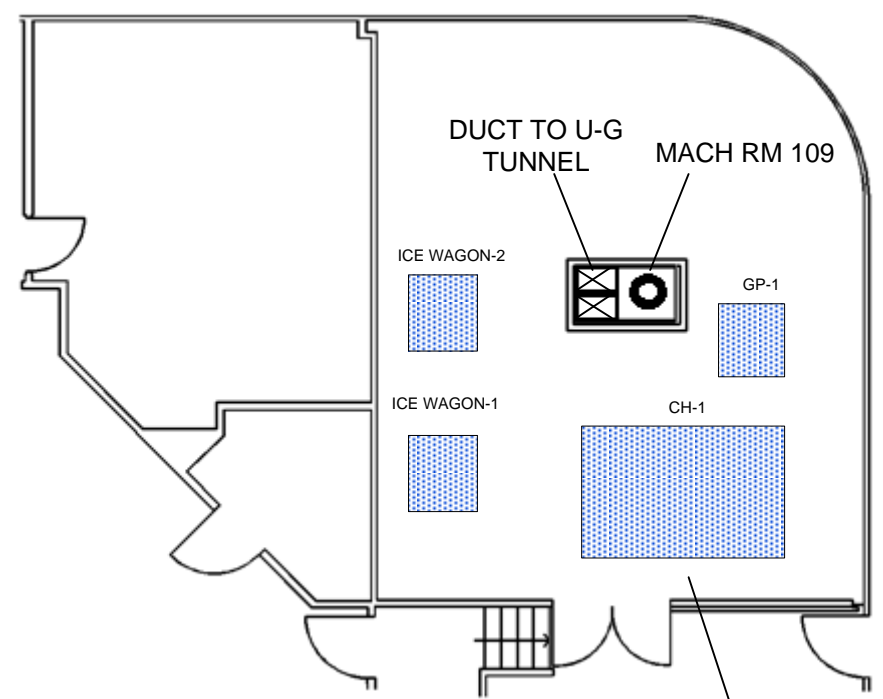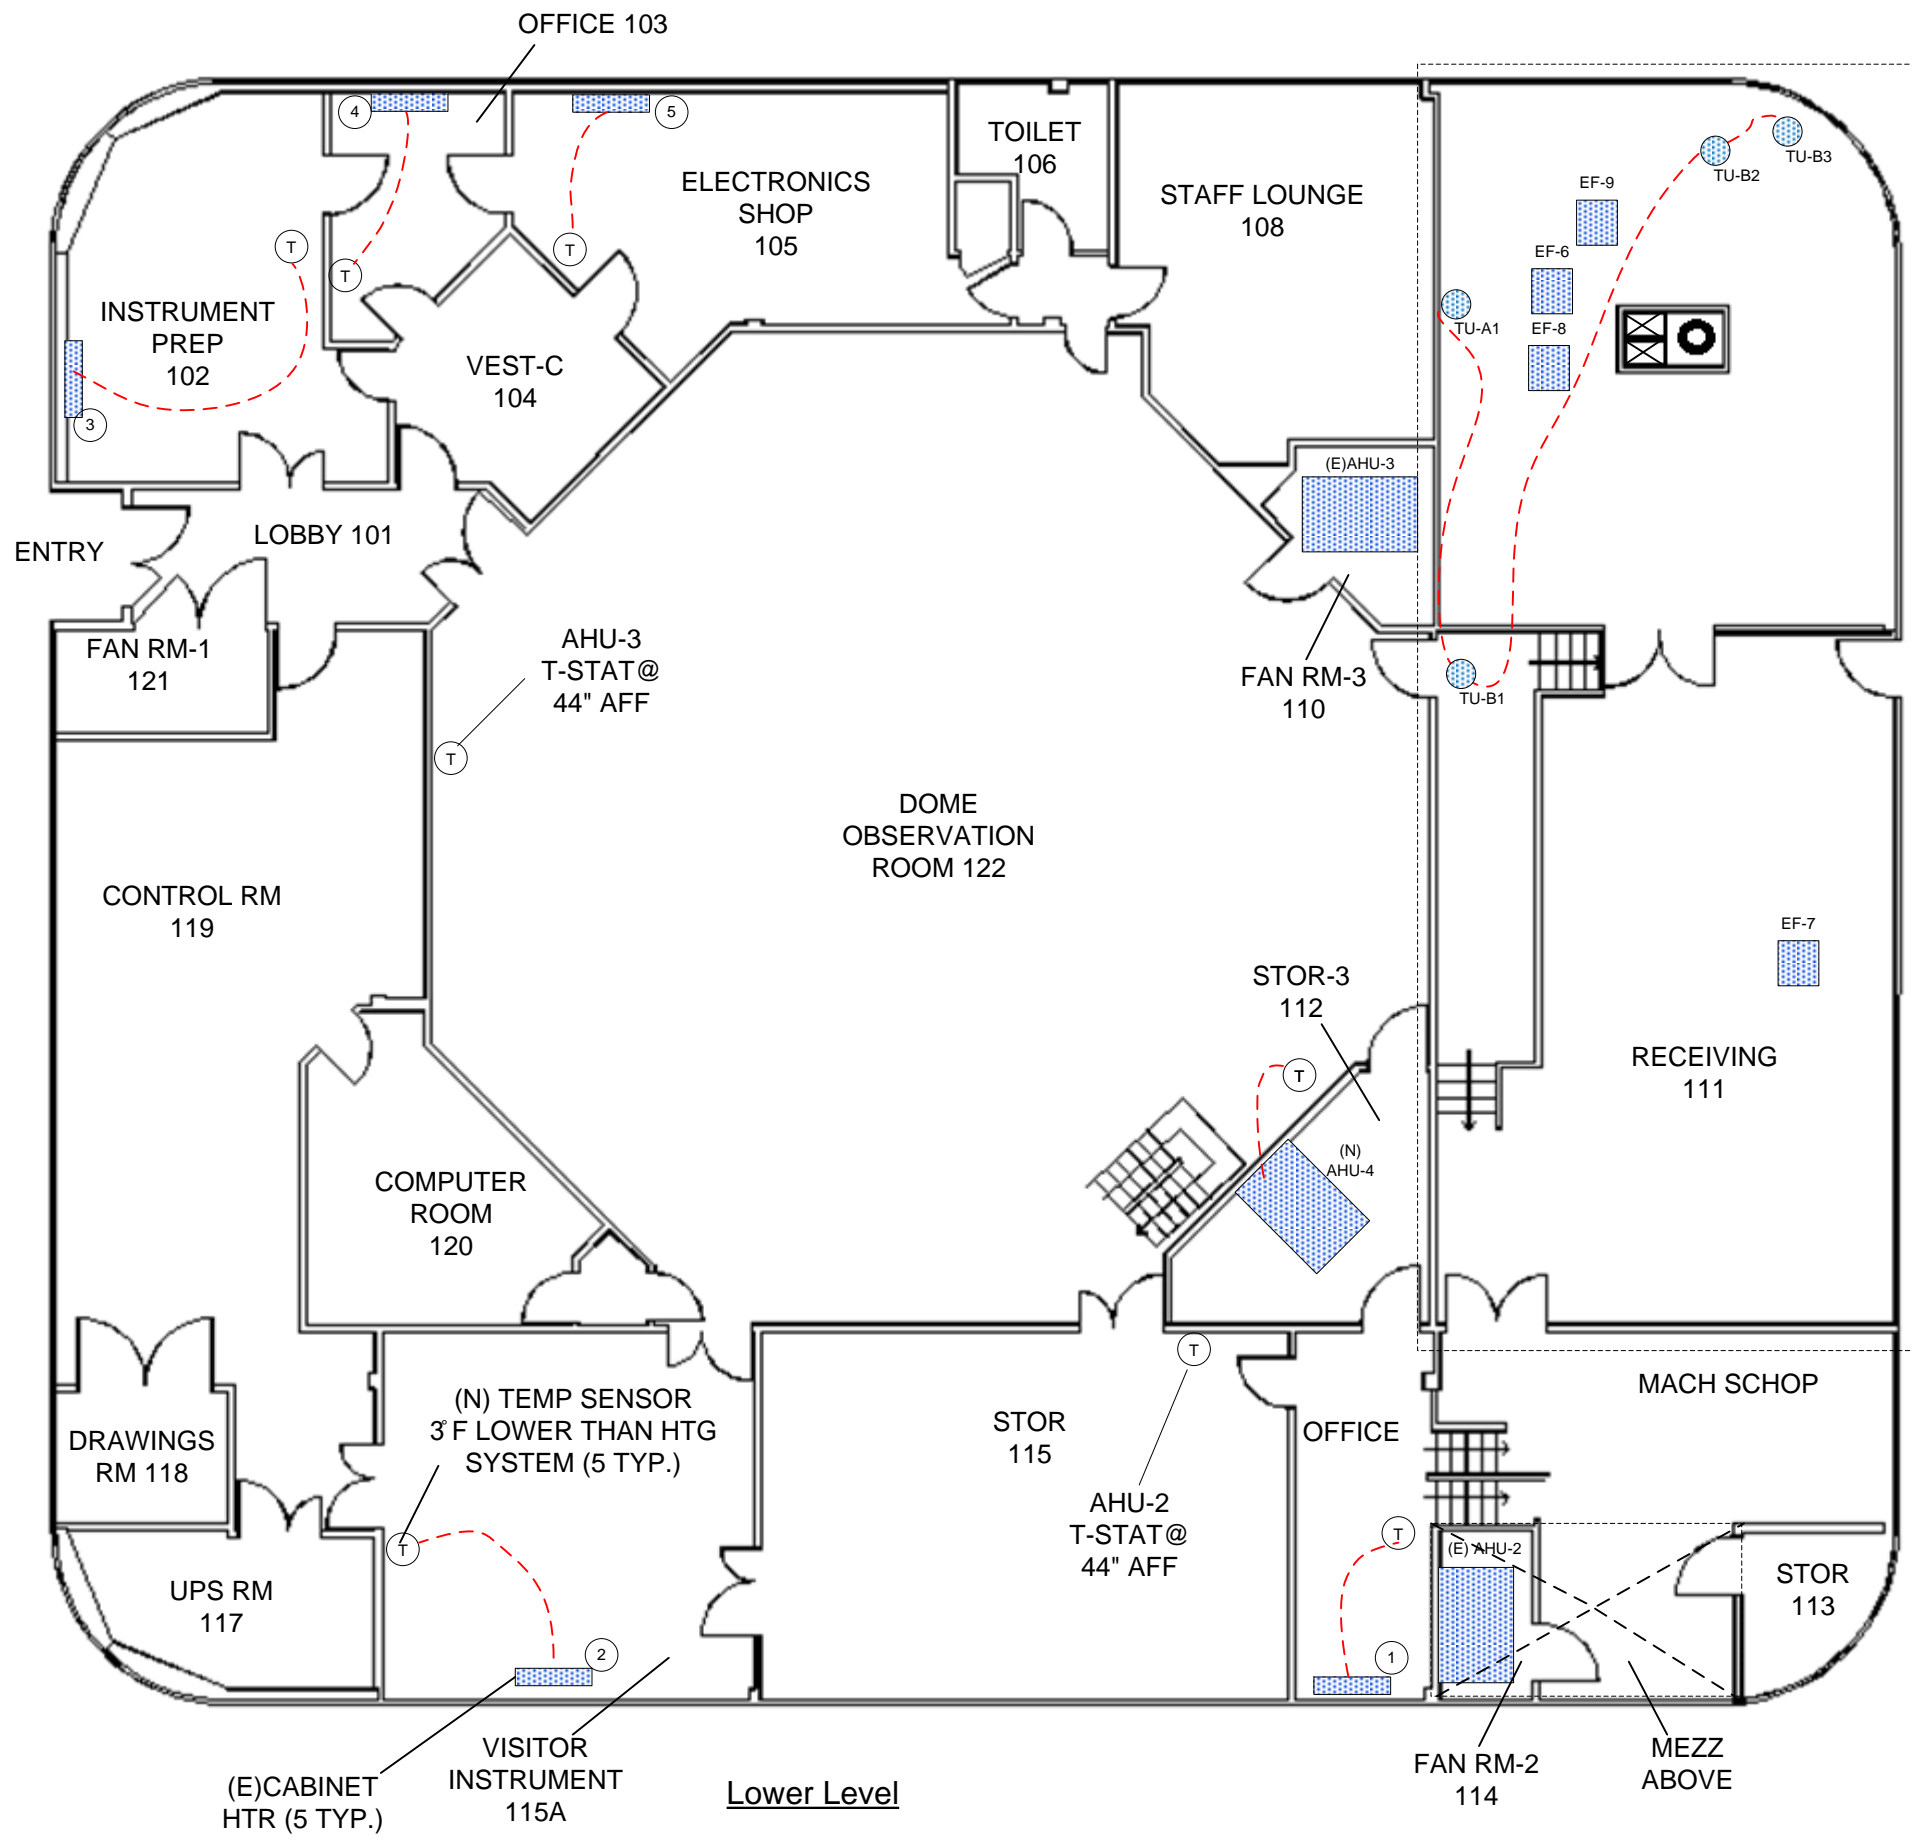

Lower Level - Northeast

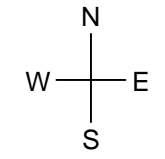

As Built

HVAC/Controls
Security/Access Controls
Service and Monitoring

BIAC

Schneider
Electric

NASA INFRARED TELESCOPE FACILITY

FLOOR PLAN

PROJECT:

REVISIONS:

DRAWN BY: AG

ENG. BY: JL

CHK'D BY: JL

DATE: 8-13-13

JOB NO.

DWG NO. TC-14 of 14